



NOTE: MD 140 IS ASSUMED TO RUN
IN AN EAST-WEST DIRECTION.


SIGNS

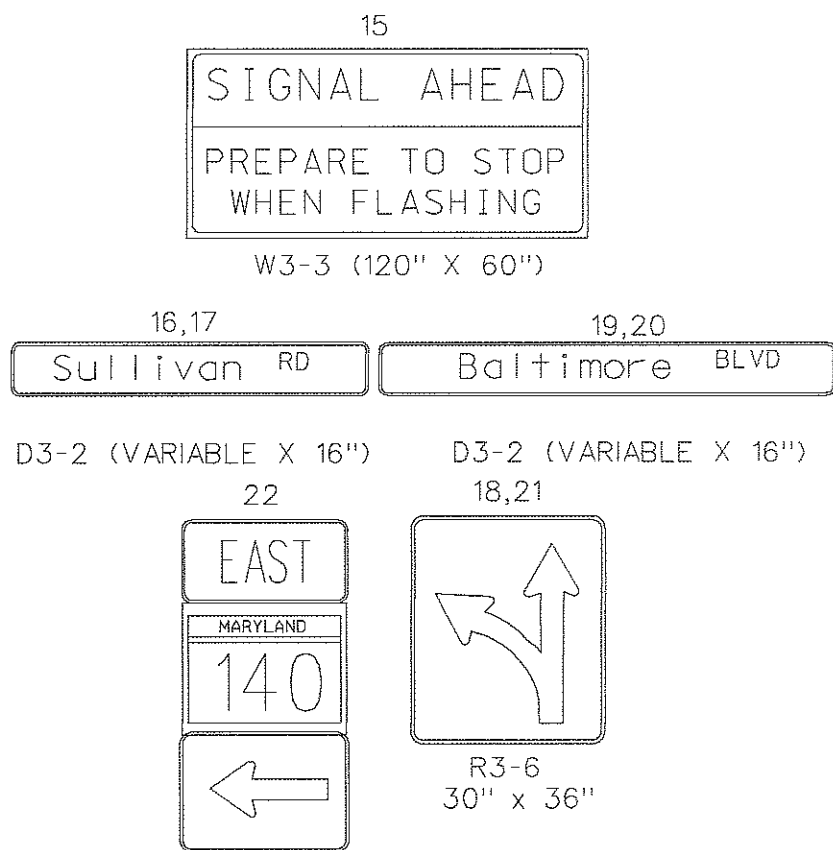

SIGNALS

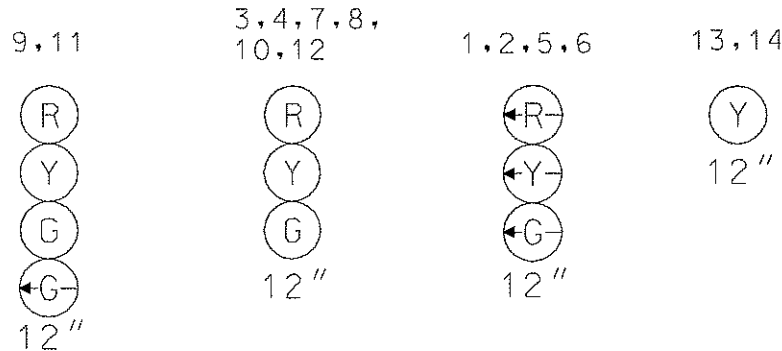


NEMA PHASING

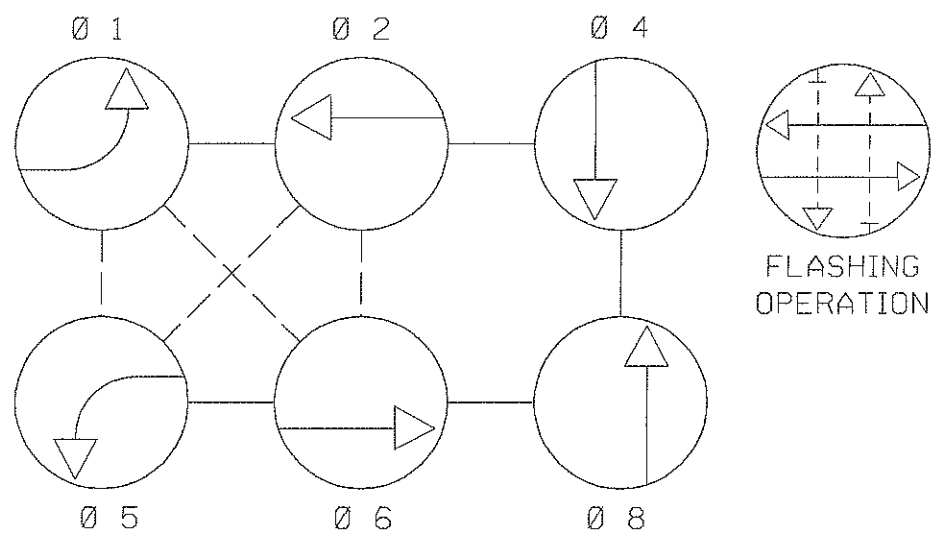

PHASING NOTES:

- 1. PHASES ASSOCIATED BY A SOLID LINE WILL NOT OPERATE CONCURRENTLY.
- 2. PHASES ASSOCIATED BY A DASHED LINE WILL OPERATE CONCURRENTLY.

NOTE: THERE ARE (2) TWO HANDHOLES LOCATED WITHIN THIS BREAK. THEY ARE LOCATED THE FOLLOWING DISTANCES EAST OF SULLIVAN ROAD.
198' - (3' FROM ROAD EDGE)
246' - (4' FROM ROAD EDGE).

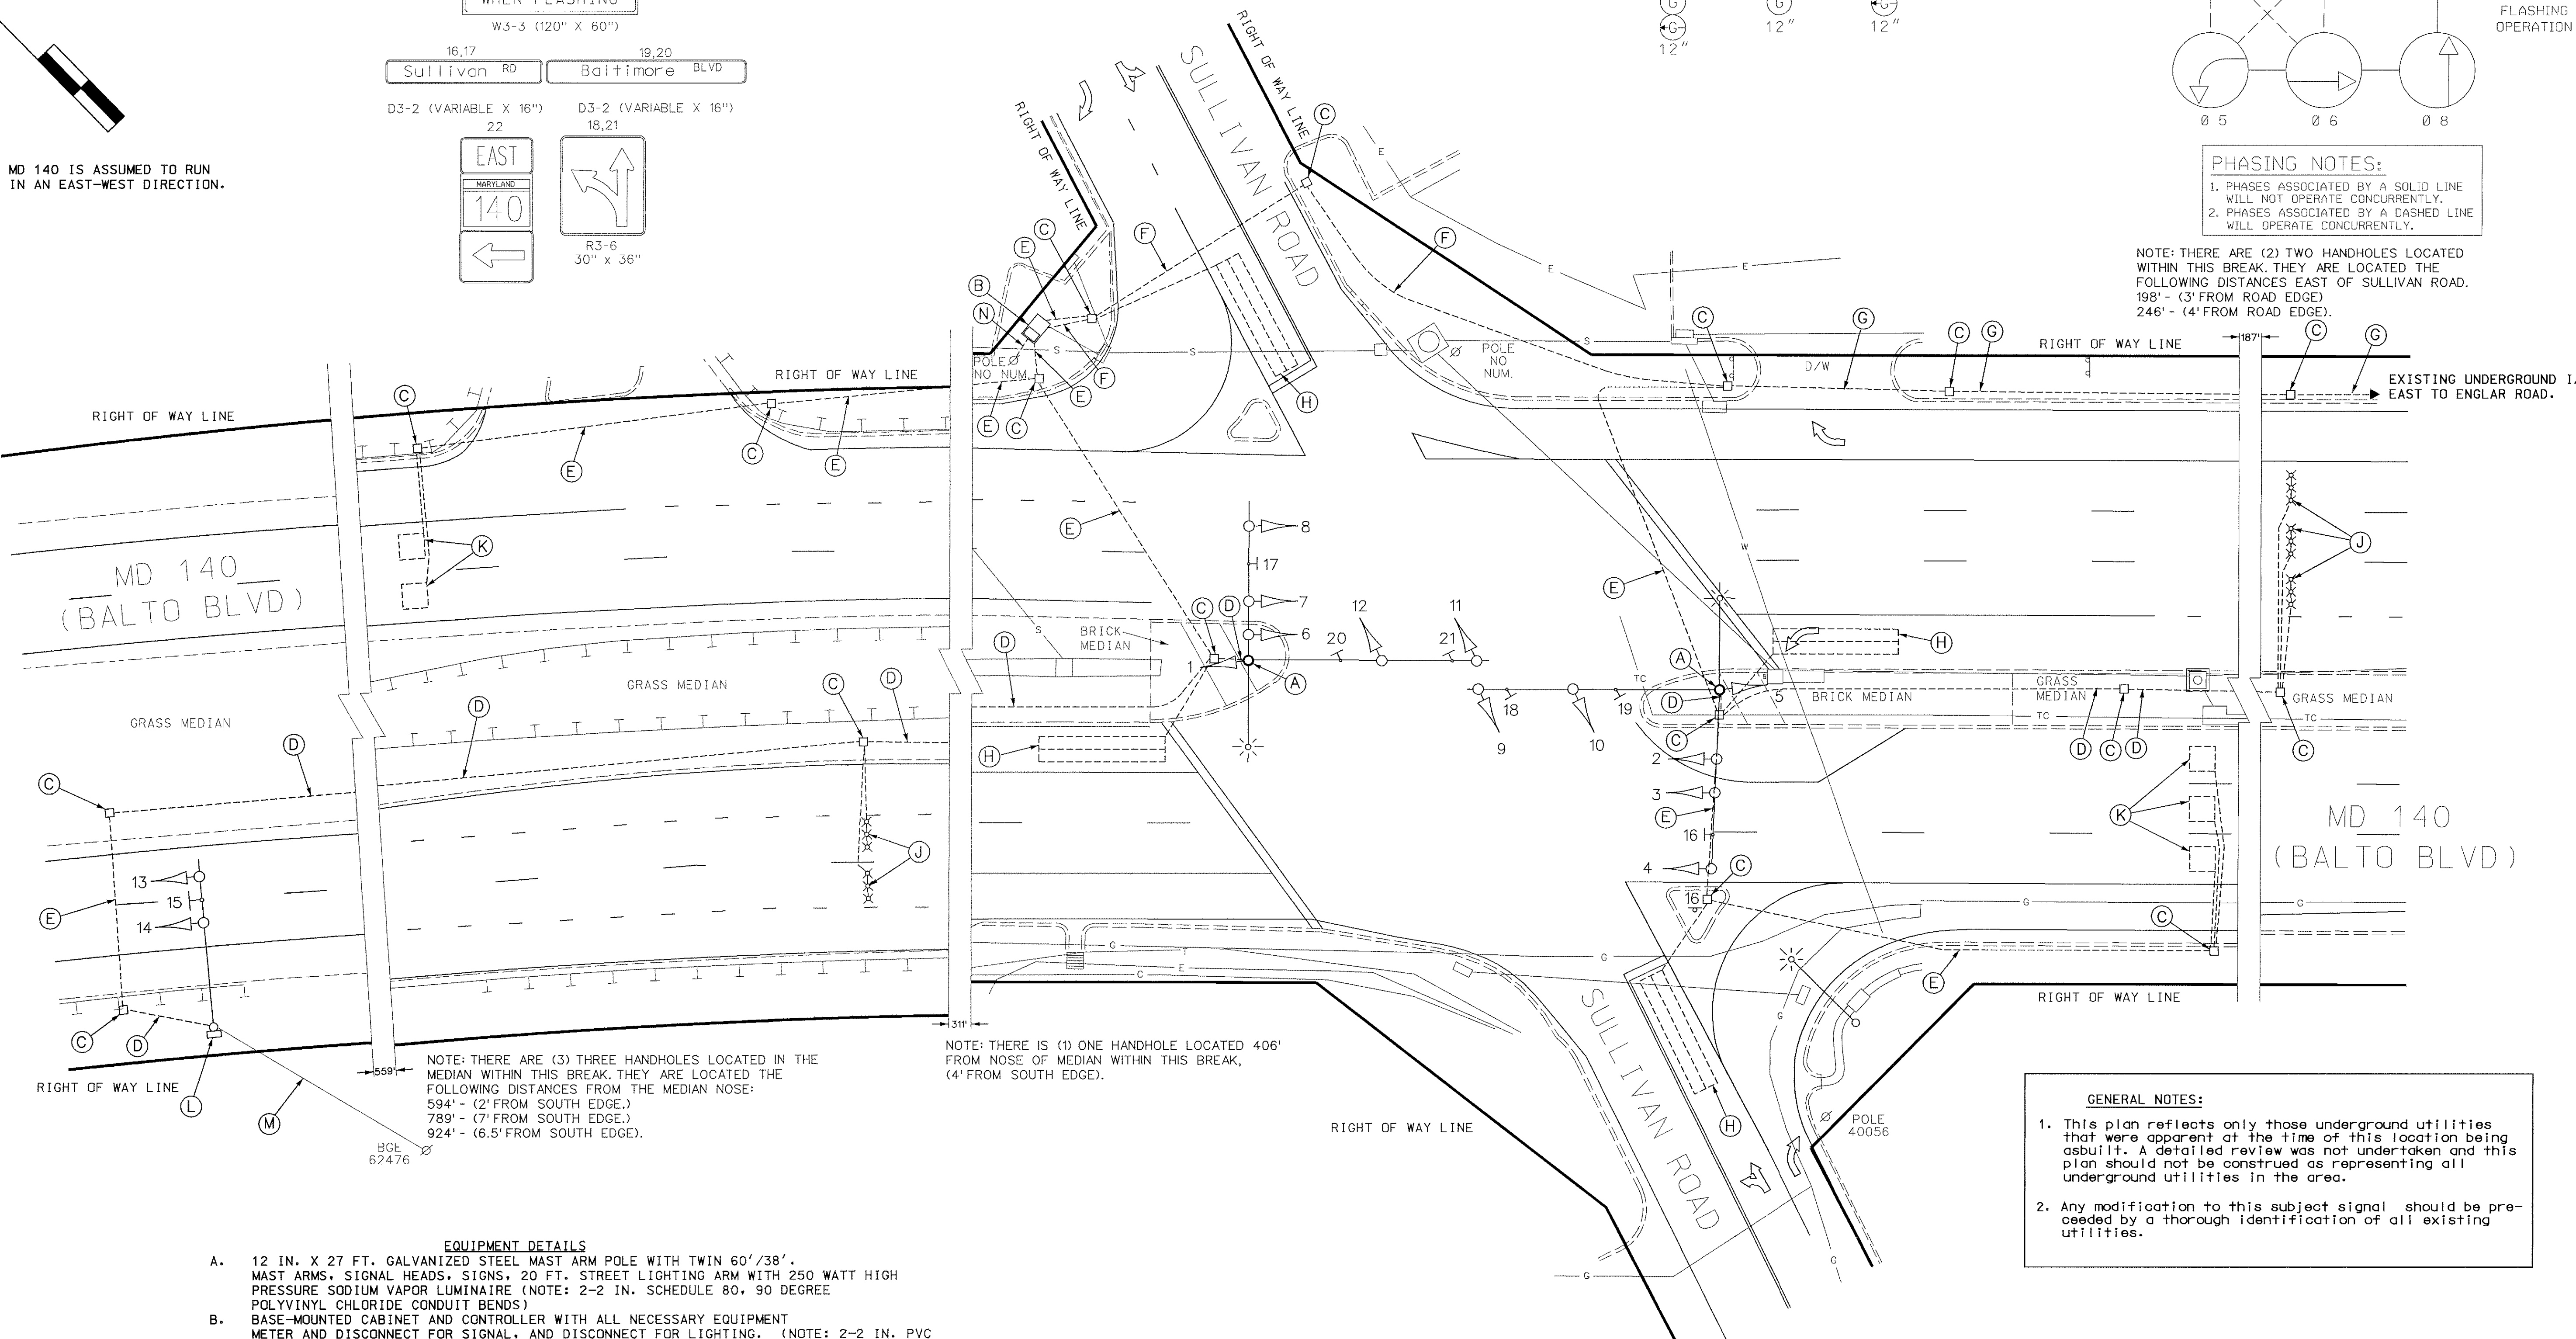

NOTE: THERE ARE (3) THREE HANDHOLES LOCATED IN THE MEDIAN WITHIN THIS BREAK. THEY ARE LOCATED THE FOLLOWING DISTANCES FROM THE MEDIAN NOSE:
594' - (2' FROM SOUTH EDGE.)
789' - (7' FROM SOUTH EDGE.)
924' - (6.5' FROM SOUTH EDGE.)

NOTE: THERE IS (1) ONE HANDHOLE LOCATED 406' FROM NOSE OF MEDIAN WITHIN THIS BREAK, (4' FROM SOUTH EDGE).

EQUIPMENT DETAILS

- A. 12 IN. X 27 FT. GALVANIZED STEEL MAST ARM POLE WITH TWIN 60'/38' MAST ARMS, SIGNAL HEADS, SIGNS, 20 FT. STREET LIGHTING ARM WITH 250 WATT HIGH PRESSURE SODIUM VAPOR LUMINAIRE (NOTE: 2-2 IN. SCHEDULE 80, 90 DEGREE POLYVINYL CHLORIDE CONDUIT BENDS)
- B. BASE-MOUNTED CABINET AND CONTROLLER WITH ALL NECESSARY EQUIPMENT METER AND DISCONNECT FOR SIGNAL, AND DISCONNECT FOR LIGHTING. (NOTE: 2-2 IN. PVC SCHEDULE 80, 2-3 IN. PVC 90 DEGREE POLYVINYL CHLORIDE BENDS)
- C. HANDHOLE
- D. 2" SCHEDULE 80 RIGID PVC CONDUIT.
- E. 3" SCHEDULE 80 RIGID PVC CONDUIT.
- F. 3" SCHEDULE 80 RIGID PVC CONDUIT WITH INTERCONNECT.
- G. 2" SCHEDULE 80 RIGID PVC CONDUIT WITH INTERCONNECT.
- H. INSTALL 6"X30' QUADRUPOLE (3-6-3 TURNS) LOOP DETECTOR ENCASED IN 1/4 INCH FLEXIBLE TUBING.
- J. MICRO LOOP PROBE.
- K. 6' X 6' LOOP DETECTOR ENCASED IN 1/4 INCH FLEXIBLE TUBING (4-TURNS).
- L. 12" X 21' GALVANIZED STEEL MAST ARM POLE WITH A 38' MAST ARM, POLE MOUNTED CABINET AND CONTROLLER, TRAFFIC SIGNAL HEADS AND SIGN. (NOTE: 1-2" SCHEDULE 80, POLYVINYL CHLORIDE BEND.)
- M. EXISTING OVERHEAD ELECTRICAL SERVICE BY BGE
- N. EXISTING UNDERGROUND ELECTRICAL SERVICE BY BGE.

GENERAL NOTES:

- 1. This plan reflects only those underground utilities that were apparent at the time of this location being asbuilt. A detailed review was not undertaken and this plan should not be construed as representing all underground utilities in the area.
- 2. Any modification to this subject signal should be preceded by a thorough identification of all existing utilities.

GEOMETRIC LEGEND	
PROPOSED	---
EXISTING	----
LEGEND OF UNDERGROUND AND OVERHEAD UTILITIES	
AERIAL CABLE	—A—A—
ELECTRIC	—E—E—
TELEPHONE	—T—T—
GAS	—G—G—
SEWER	—S—S—
WATER	—W—W—
CABLE TV	—TV—TV—

REVISION "D" ASBUILT

3874.dgn

REVISIONS	APPROVALS
11-2-00 ASBUILT SHA NO: CL7835176 R.R.Z. 10/98 SIGNAL MODIFICATION FOR ROADWAY WIDENING SHA NO: CL7835176	TEAM LEADER, TRAFFIC ENGINEERING DESIGN DIVISION ASST. CHIEF, TRAFFIC ENGINEERING DESIGN DIVISION CHIEF, TRAFFIC ENGINEERING DESIGN DIVISION DIRECTOR, TRAFFIC & SAFETY
B REVISED 2/14/84 POLE RELOCATED IN SOUTH EAST QUADRANT SHA NO: CL-612-501-785	
A RELOCATE STEEL POLES & SIGNAL NEW CONT. T.B. SHA NO: CL-612-501-785	

MARYLAND DOT - STATE HIGHWAY ADMINISTRATION
Office of Traffic & Safety
TRAFFIC ENGINEERING DESIGN DIVISION
MD 140 AND SULLIVAN ROAD

DRAWN BY: J. GORDON	F.A.P. NO.	TS NO. 1577D	SHEET NO. 1 OF 1
CHECKED BY: MEL	S.H.A. NO.		
SCALE: 1" = 20'	COUNTY: CARROLL	T.I.M.S. NO.	
DATE: 4/5/79	LOG MILE: 06014010.04		